


FOUNDATION / FLOOR PLAN

BUILDING CODES: ALL CONSTRUCTION SHALL COMPLY WITH THE REQUIREMENTS OF ANY AND ALL APPLICABLE STATE, COUNTY AND LOCAL BUILDING CODES OR REGULATIONS INCLUDING BUT NOT LIMITED TO THE FOLLOWING: -2015 INTERNATIONAL RESIDENTIAL CODE (IRC) AND/OR AS AMENDED OR ADOPTED BY LOCAL MUNICIPAL AUTHORITY

ENGINEERING NOTE:

THERE HAS NOT BEEN ANY STRUCTURAL, MECHANICAL, ELECTRICAL OR SITE ENGINEERING PERFORMED FOR THIS PROJECT. IT SHALL BE THE RESPONSIBILITY OF OTHERS TO OBTAIN DESIGN DATA FROM A LICENSED ENGINEER FOR THESE SYSTEMS. ENGINEERING SHALL CONFORM WITH ALL APPLICABLE LOCAL AND/OR STATE BUILDING CODES AND REGULATIONS.

CONSTRUCTION NOTES: -ALL WOOD TO BE PRESSURE TREATED SP #2 OR BETTER -ALL CONCRETE TO BE 3500 PSI MINIMUM -ALL HARDWARE TO BE GALVANIZED, POWDER-COATED OR STAINLESS STEEL, OR AS NOTED

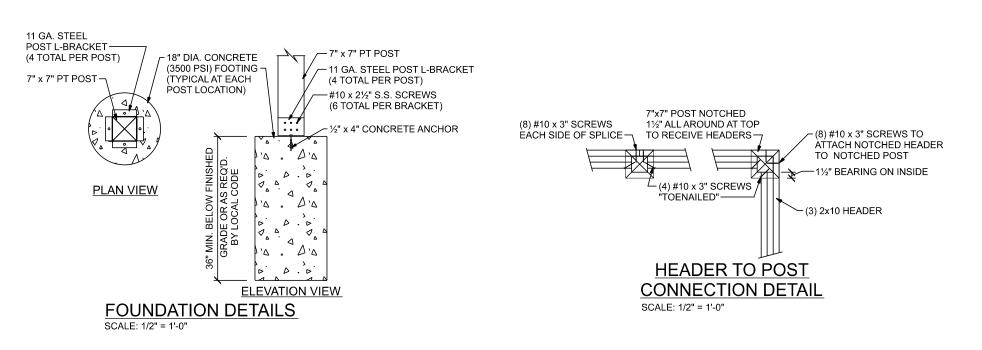

REVISIONS

SCALE: 1/4" = 1'-0" U.N.O.

10 - 27

DATE APRIL 17, 2020

TITLE

ELEVATIONS PLAN SECTION DETAILS NOTES

ONE of ONE

PLOT DATE

Friday, April 17, 2020